


NOTE 24: NEW BLOWDOWN VALVE ADDED PER REV B.

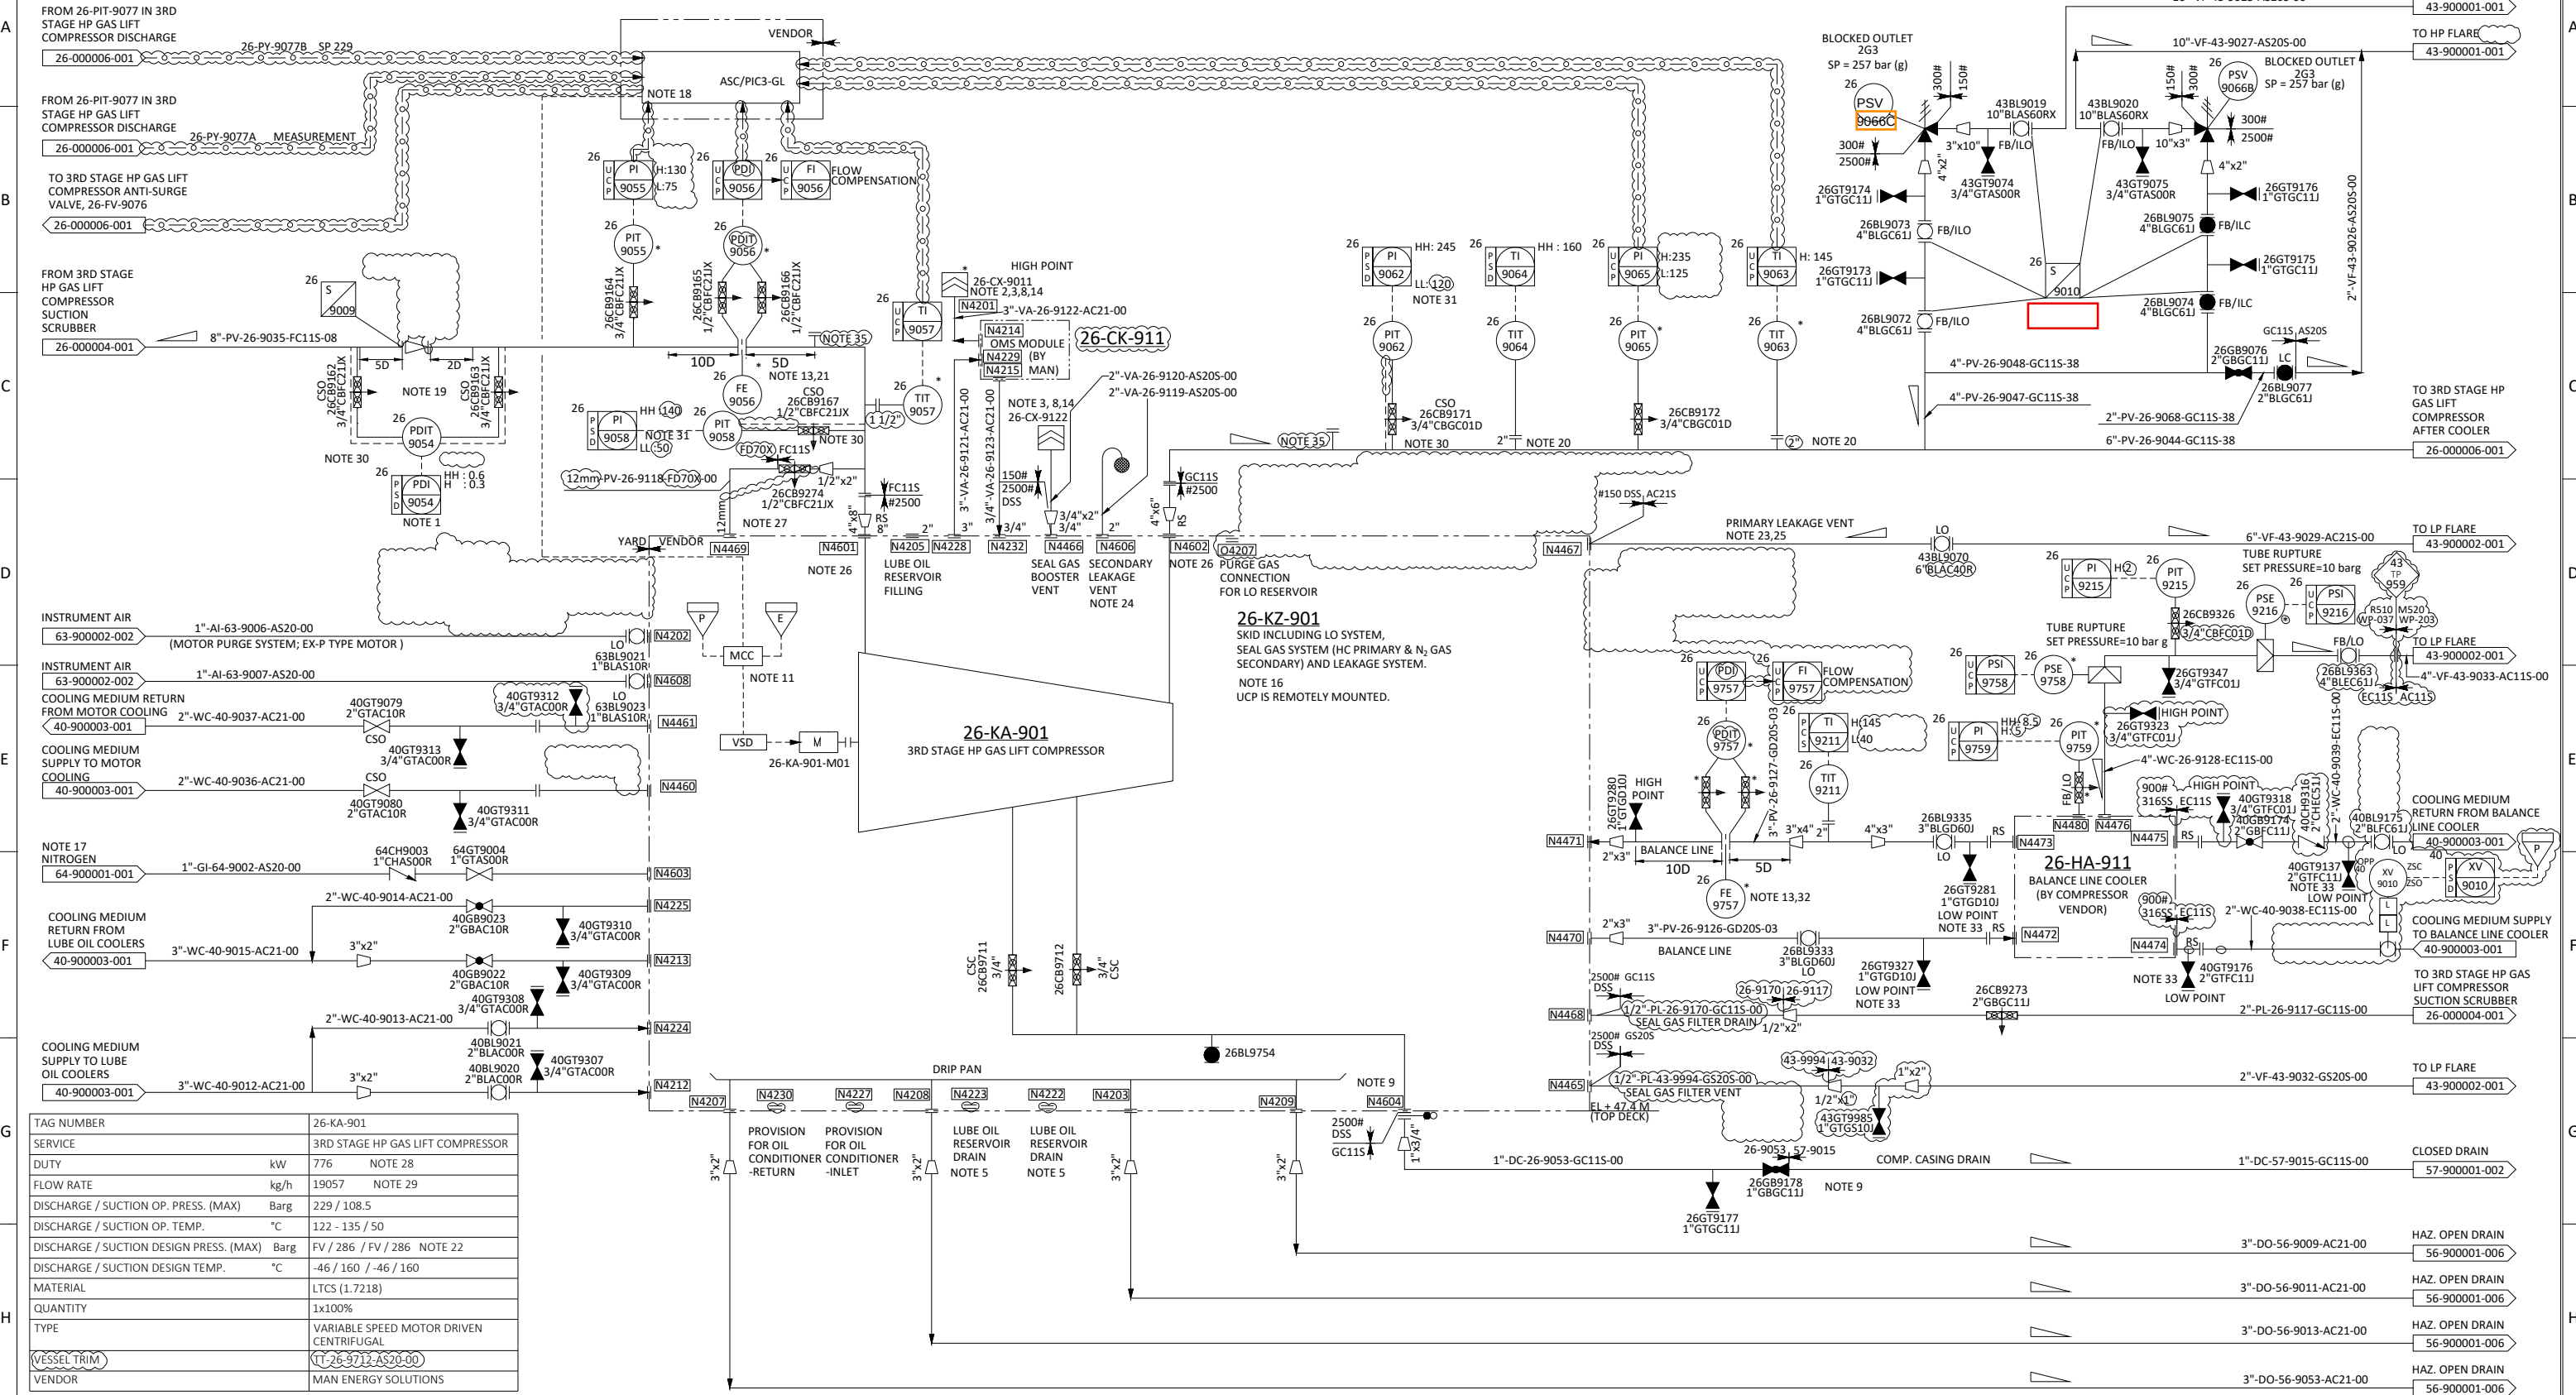

- NOTES:
- 26-PDI-9054 HH INITIATE PRESSURIZED COMPRESSOR STOP.
 - LUBE OIL RESERVOIR VENT. OIL MIST SEPRATOR INSTALLED OFF-SKID.
 - ATMOSPHERIC VENT.
 - HIGH POINT VENT AND LOW POINT DRAIN TO BE FINALIZED BY PIPING AS PER PIPING LAYOUT.
 - OIL CHANGE BY USING TEMPORARY ARRANGEMENT WITH HOSES.
 - DELETED.
 - DELETED.
 - FLAME ARRESTER INCLUDES FLAME FILTER AND LOCATED AT END OF PIPE.
 - MANUAL DRAIN PRIOR TO EACH START-UP. PUSH BUTTON WITH PERMISSIVE FOR START-UP SEQUENCE.
 - DELETED.
 - COMPRESSOR MOTOR EQUIPPED WITH VARIABLE SPEED DRIVE (VSD). FOR VSD MONITORING AND TRIP FUNCTION, REFER VENDOR DRAWING NO. (0D204-CIT-P-XB-ER252A-000001-002). VSD AND MCC NOT IN COMPRESSOR VENDOR SCOPE.
 - DELETED.
 - UPSTREAM STRAIGHT RUN MIN. 10xD. DOWNSTREAM STRAIGHT RUN MIN. 5xD.
 - VENT ROUTED TO SAFE LOCATION.
 - DELETED.
- PRIMARY SEAL GAS IS TAKEN DOWNSTREAM LAST COMPRESSING STAGE (8TH STAGE) SKID INTERNAL DESIGN.
 - SECONDARY SEAL GAS AND SEPARATION GAS.
 - ANTI-SURGE CONTROL (ASC) AND PRESSURE CONTROL (PIC3-GL) BY UCP. COMPRESSOR DISCHARGE PRESSURE IS CONTROLLED WITH VSD.
 - SUCTION STRAINER (COMMISSIONING PHASE ONLY) WITH STRAIGHT PIPE RUNS MIN. 5xD UPSTREAM AND 2xD DOWNSTREAM TO AVOID DAMAGE DUE TO TURBULENCE. HIGH ALARM AT 40 % OF DESIGN DP AND COMPRESSOR HIGH-HIGH TRIP AT 50 % OF DESIGN DP (RECOMMENDED BY COMPRESSOR VENDOR).
 - INSULATION THICKNESS TO BE TAKEN INTO CONSIDERATION ON TW SELECTION.
 - DIFFERENTIAL PRESSURE BASED ORIFICE TYPE VOLUME FLOW METER.
 - DESIGN PRESSURE IN EXTERNAL SYSTEM DOWNSTREAM COMPRESSOR 257 BARG.
 - FROM SEAL GAS SYSTEM RUPTURE DISCS.
 - MAX BACK-PRESSURE 0.005 BARG.
 - MAX BACK-PRESSURE 1.5 BARG.
 - BOTTOM ENTRY FOR SUCTION AND DISCHARGE NOZZLES.
 - COMPRESSOR SUCTION PRESSURE TO PDIT FOR PRIMARY SEAL GAS.
 - POWER AT COMPRESSOR COUPLING FOR CASE 7B.
 - CASE 8A. CORRESPONDING VOL FLOW 10 MMSCFD / 0.28 Msm³ / d.
 - SAFETY CRITICAL HEAT TRACING - HYDRATE MITIGATION (25°C)
 - LI SET POINT IS OVERRIDEN AT START-UP.
 - DIFFERENTIAL PRESSURE BASED ORIFICE TYPE VOLUME FLOW METER. BALANCE LINE TEMPERATURE 26-TIT-9211, SUCTION PRESSURE 26-PIT-9055 AND PDIT OVER ORIFICE (REF. VENDOR P&ID: 26-PDIT-9757) ARE USED FOR BALANCE LINE COOLER PROCESS GAS FLOW CALCULATION.
 - CHEMICAL CLEANING (CIP); BLEED/DRAIN CONNECTION.
 - THIS P&ID CONTAINS DCN-KP-0273-8/0389-1/332-1/0530-1/0618-1.

35. PROVISION FOR FUTURE HOT GAS BYPASS LINE.
36. THIS P&ID CONTAINS DCN-KP-0839-2/0970-1/1261-1

HOLDS:
1-23. DELETED

WORK PACKS:
WP-037 CONSTRUCTION OF NEW PROCESS MODULE R510.
DELETED.
* VENDOR SCOPE OF SUPPLY.